




ELEVACION F-F

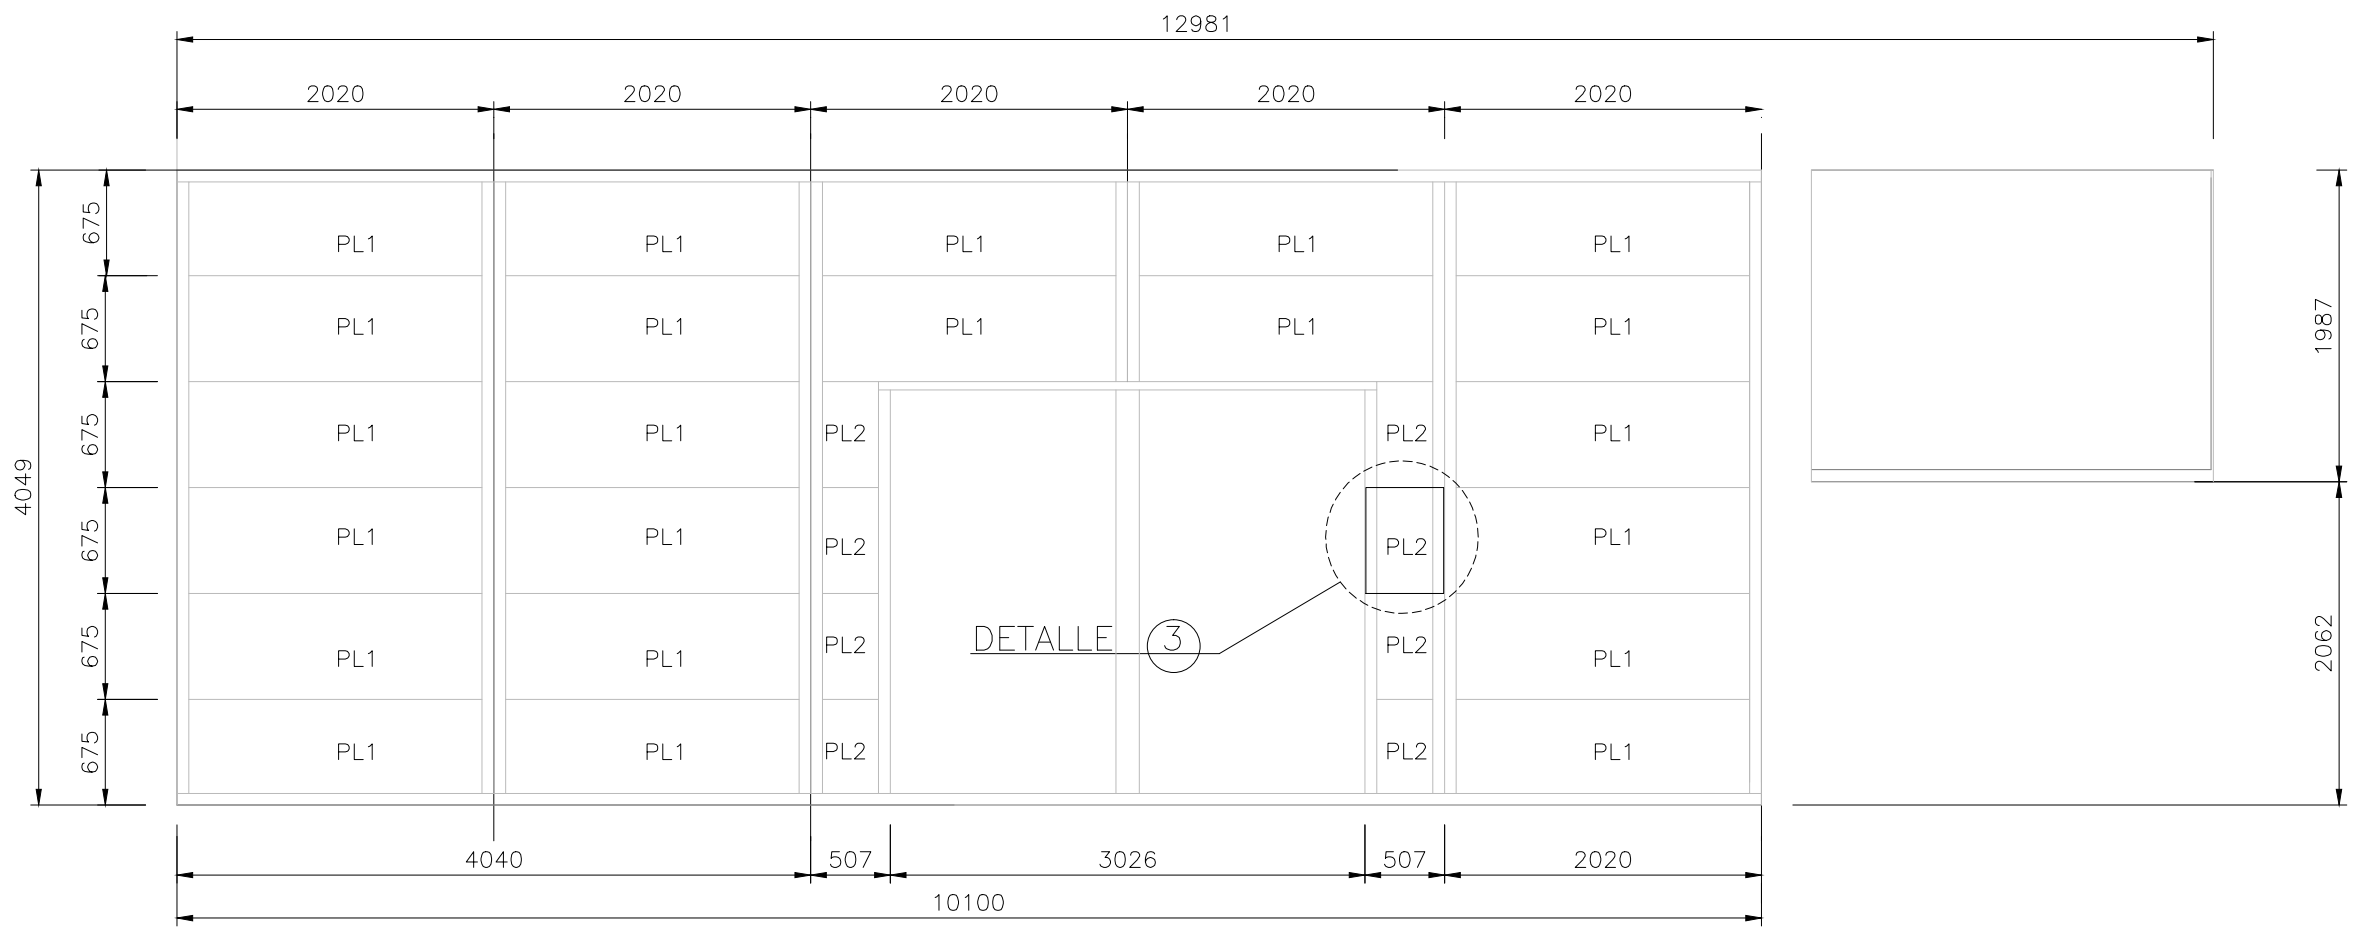


ELEVACION G-G

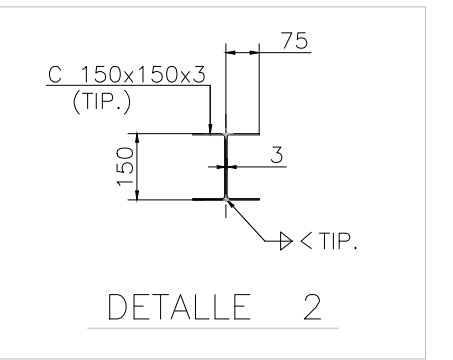


DETALLE 2

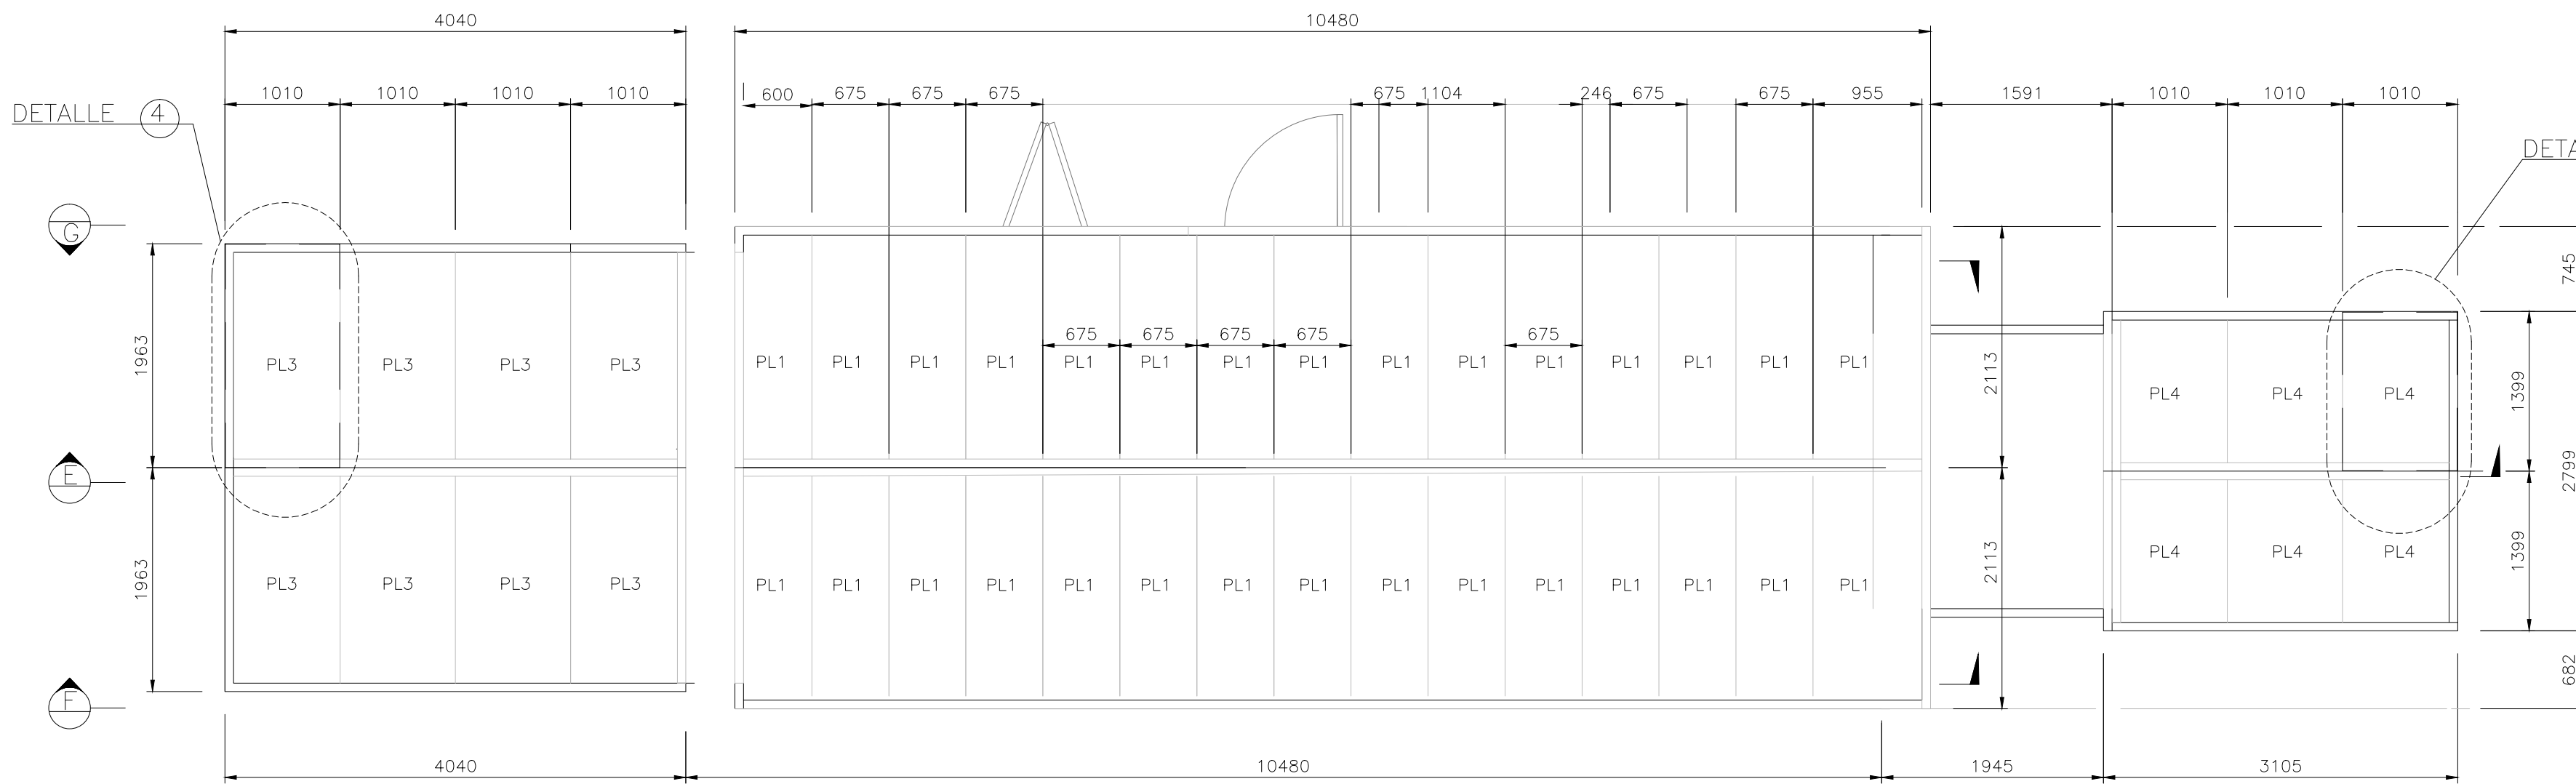


PLANTA

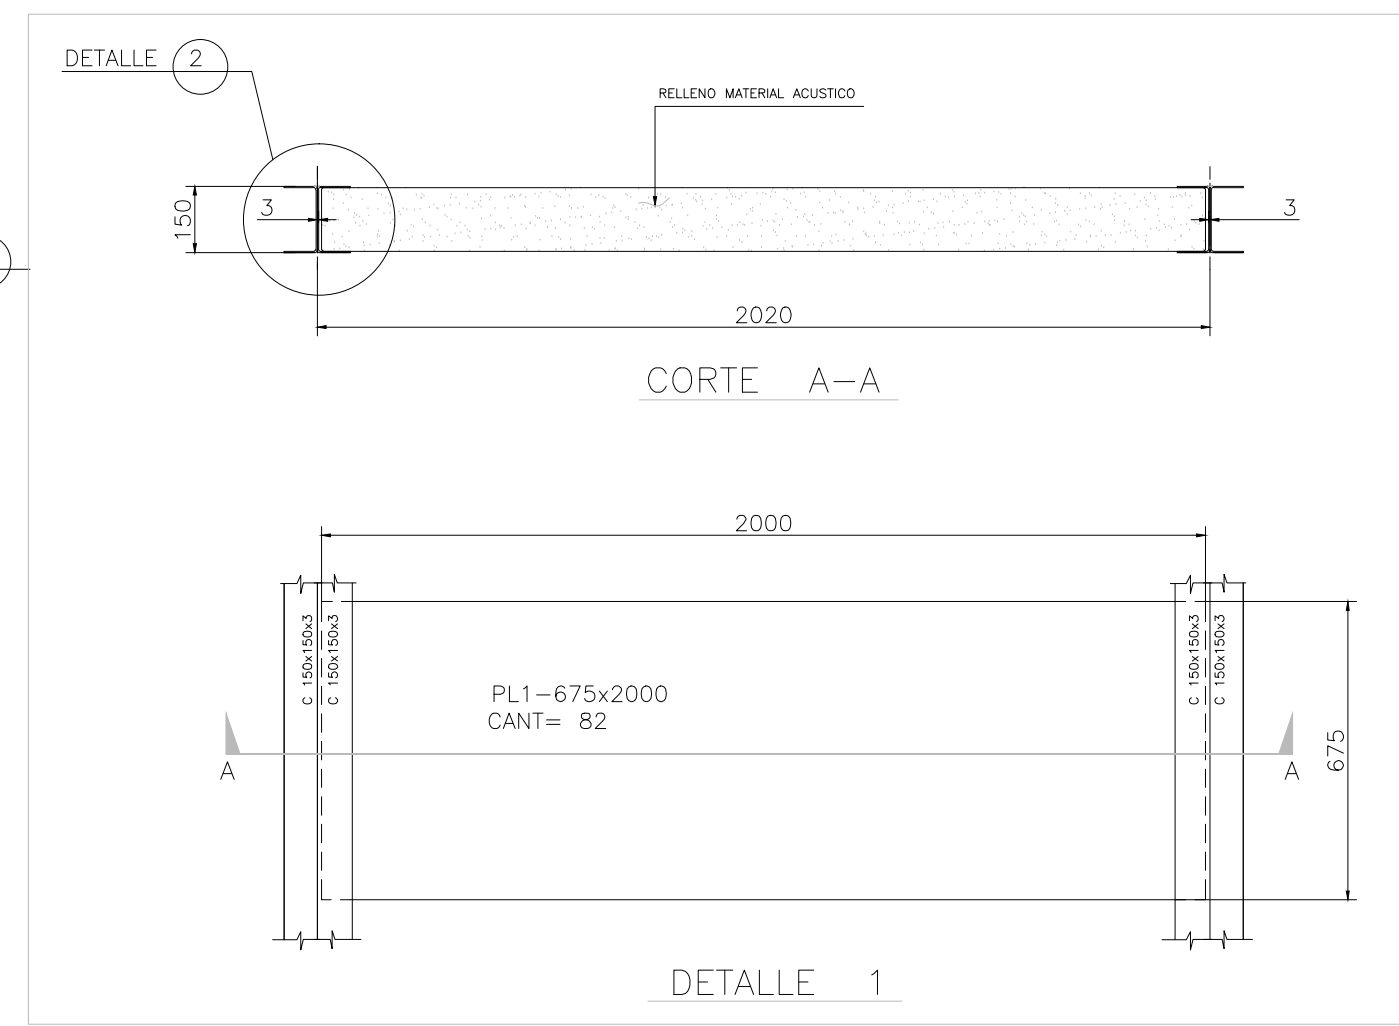


DETALLE 1

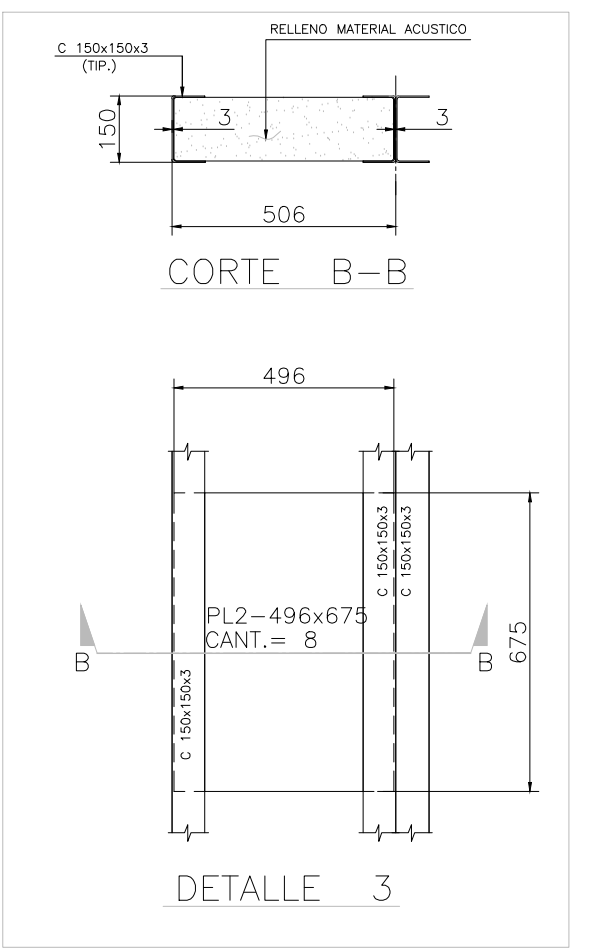


DETALLE 3

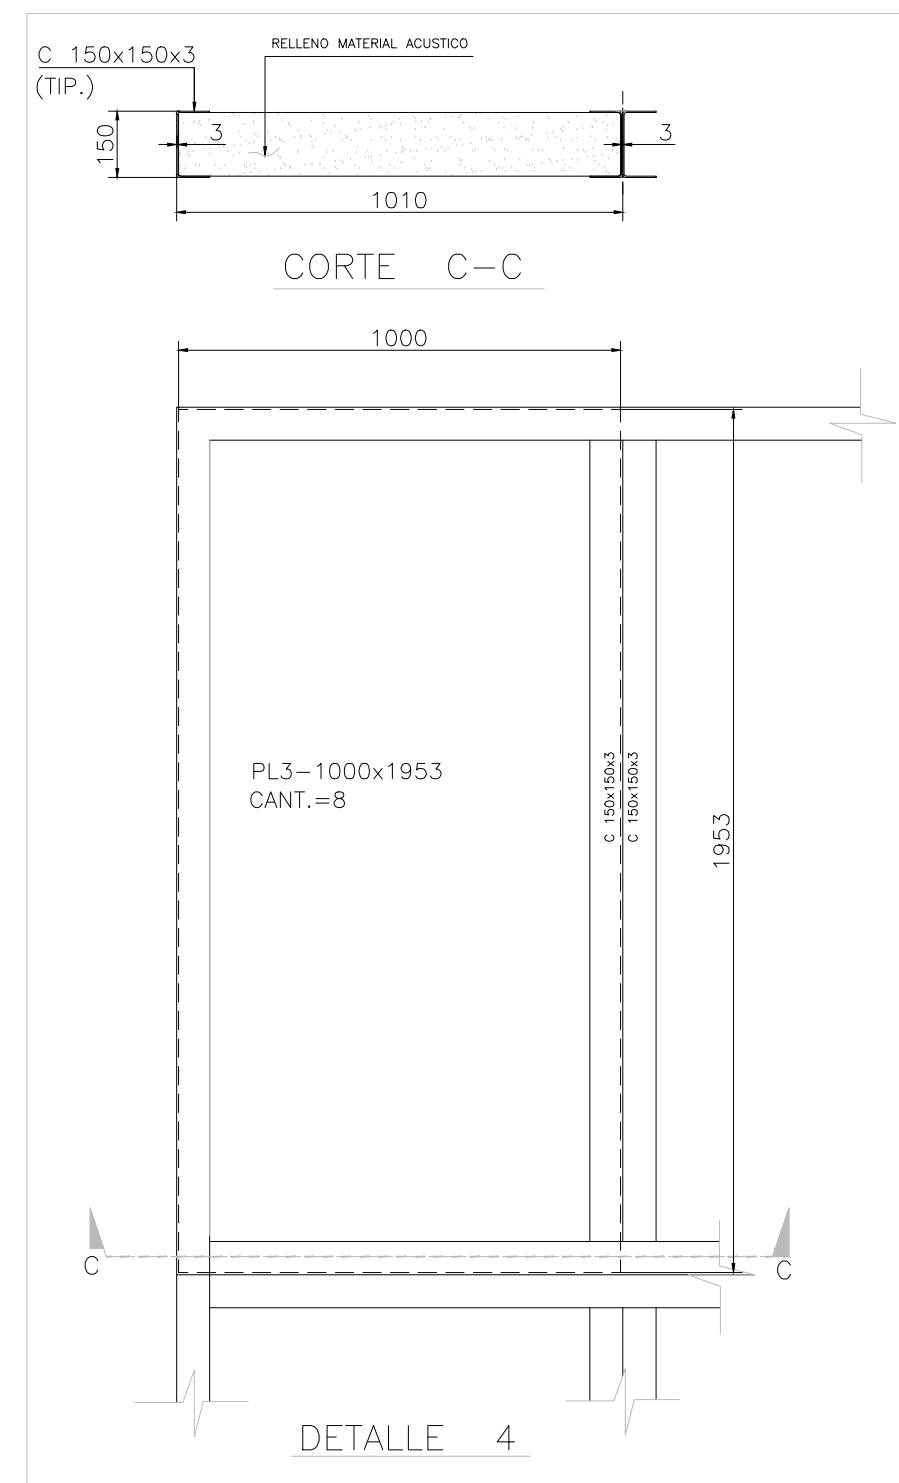


DETALLE 4

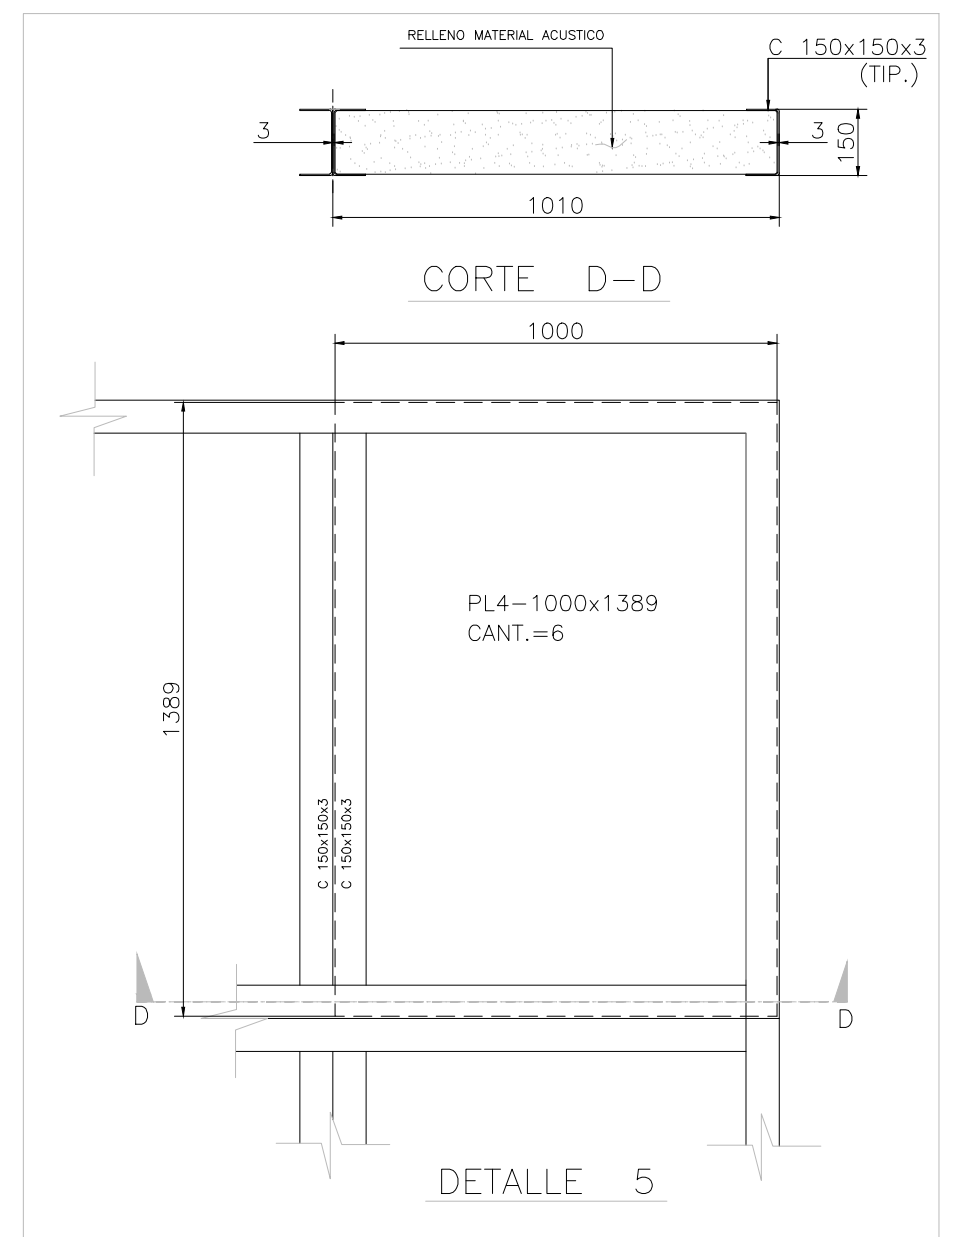

DETALLE 5

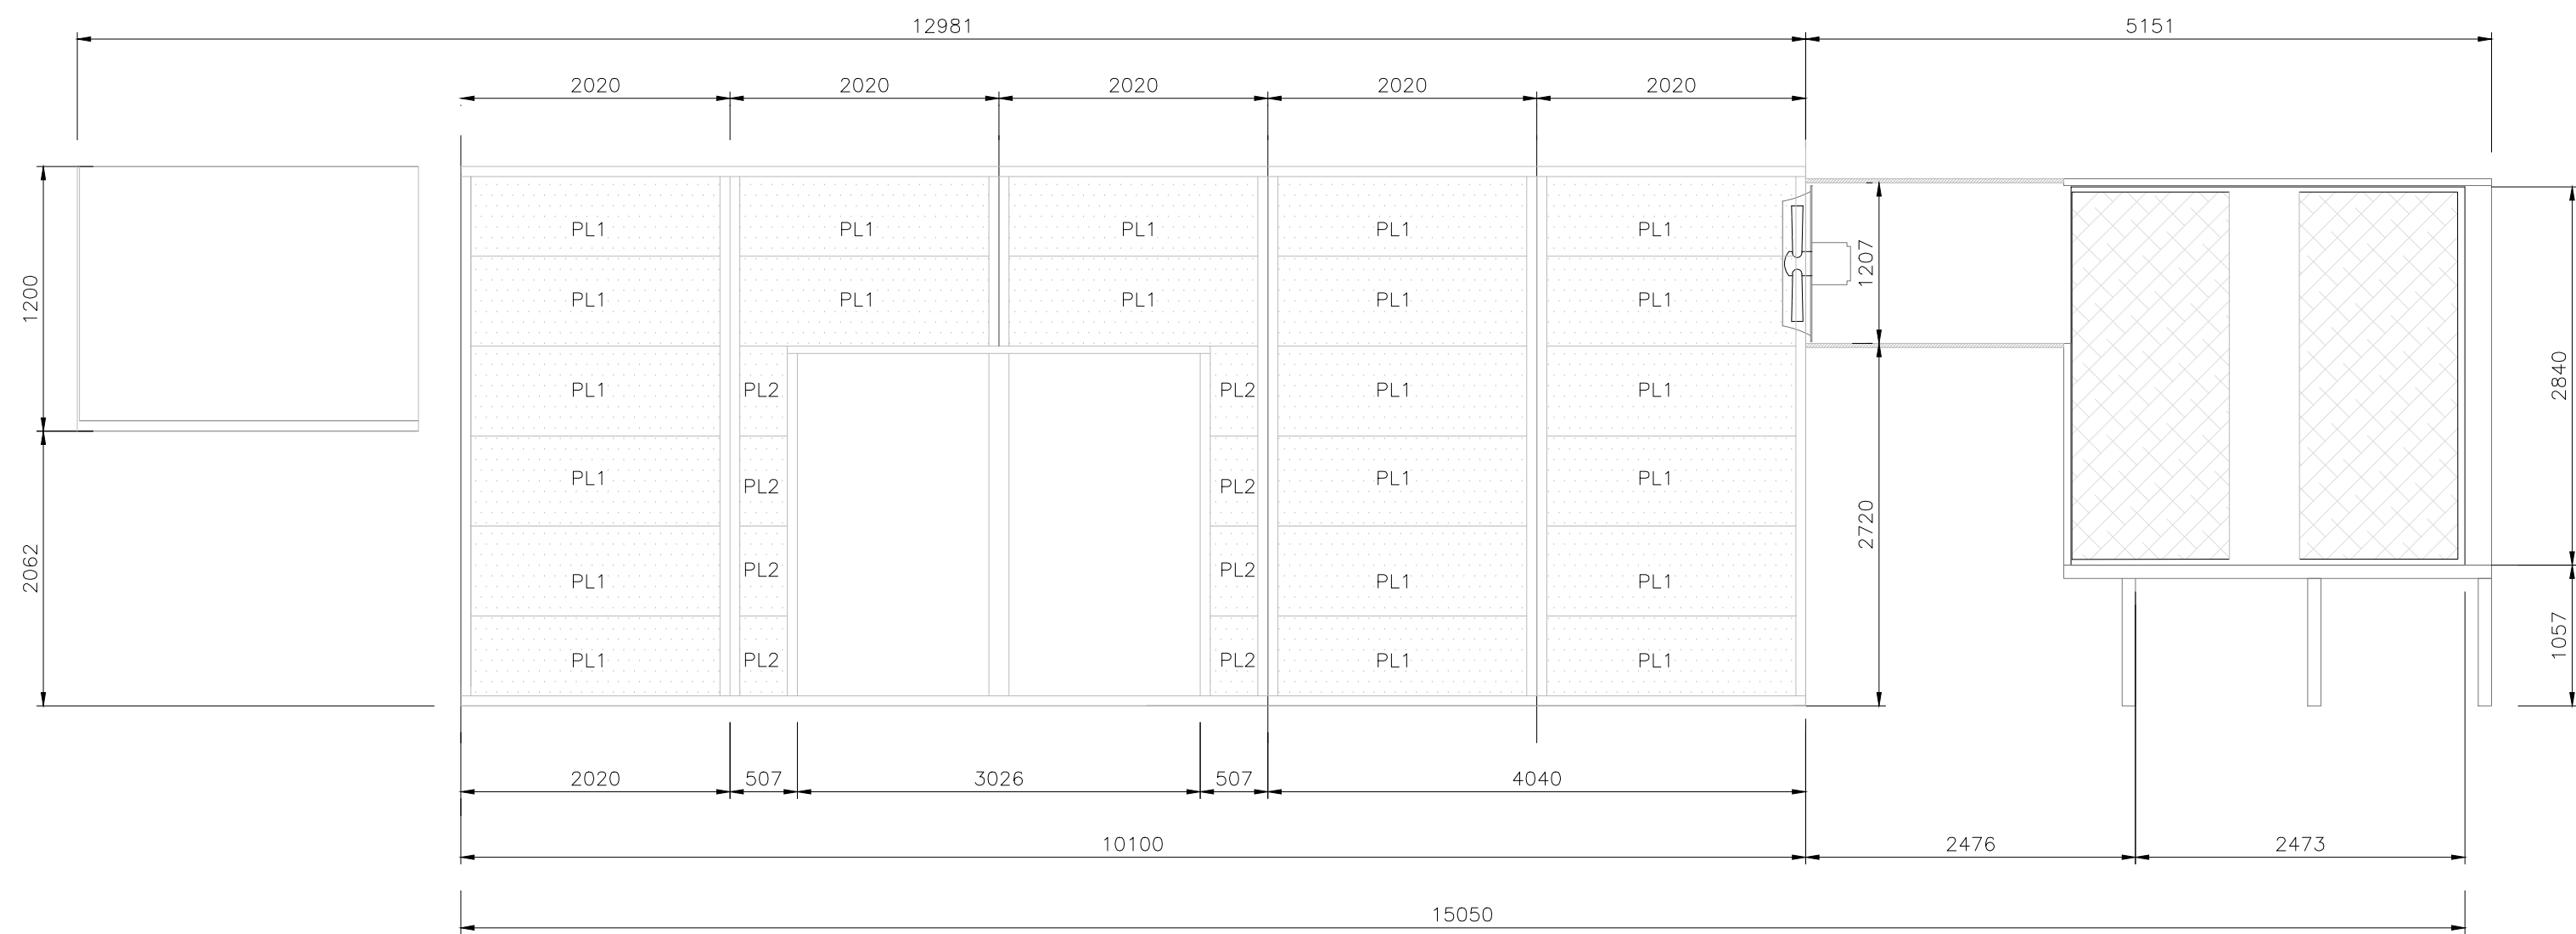

CORTE E-E

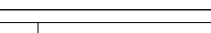										DISEÑO / DESIGNER		NOMBRE / NAME		FECHA/DATE		FIRMA / SIGNATURE		 <div>EscoChile</div>		Project/Project: TERMOGENERADOR CENTRAL MATAVERI		H						
										J. ALGUERNO I.		J. ALGUERNO I.		30.08.13		Cliente/Customer: MAESTRANZA DIESEL / SASIPA				Denominación/Description: DETALLES CONSTRUCTIVOS CABINA								
										DEBUE/DRAWN		A. APABUZA A.		30.08.13														
												REVISO / CHECKED BY		J. ALGUERNO I.		30.08.13		Web:www.escochile.cl email:info@escochile.cl		Plano/Drawing No.: MD-1158-AC-03		D1/WORK ORDER 1158						
0				AS BUILT		30.08.13		A.J.A		APROBADO / APPROVED BY		J. ALGUERNO I.		30.08.13						ESCALA/SCALE 1/50			Residencia/Revision 0		FORMATO ORIGINAL DIN A1		Páginas/Sheet 001/001	
Revision				Modificado/Modification		Fecha		Nombre																				